



## Site Technical Query - Form

SN1809-0000/XE.FRM/0001 Rev 4 03/02/2021

TQ Number:		Project:	
<b>CW2144960 -A010- 0051</b>		<b>Oyu Tolgoi Underground Project</b>	
A. To be completed by or on behalf of the Contractor			
Contractor/Sub-Contractor Name:	MCS International	Date Response	18/01/2022
Contract Title:	Booster Fan installations	Plant Area &	1693
Contract No.	CW2144960	Contractor TQ Number:	BF-0415-TQ-0051
Discipline Codes (Mandatory) D1 (CSA) - <input type="checkbox"/> D2 (MP) - <input checked="" type="checkbox"/> D3 (E&I) - <input type="checkbox"/> D4 (Other) - <input type="checkbox"/>			
Description of Technical Query (List affected drawings and specifications): <b>HVAC condenser 1693-SRM-2001-AHU-CNDA support</b> E-room HVAC Condenser 1693-SRM-2001-AHU-CNDA unit will be installed on top of 1693-SRM-2001-AHU-CNDB unit as per TQ-0045. Therefore, suitable base supports will be needed for the HVAC condenser 1693-SRM-2001-AHU-CNDA.			
<input type="checkbox"/> Routine <input checked="" type="checkbox"/> Urgent Refer Technical Query instructions			
Proposed Action (List all attachments)  The contractor is proposed the following options. <ol style="list-style-type: none"><li>1. Install the 1693-SRM-2001-AHU-CNDA unit on the wall with a triangular support. The design and calculations are attached in the appendix.</li><li>2. Each base support with two legs anchored to the floor. Place the condenser 1693-SRM-2001-AHU-CNDB at the lower level and the condenser 1693-SRM-2001-AHU-CNDA on the upper level on 2ea base support. Each support with two legs anchored to the floor. Design and calculations are attached.</li></ol>			
Effect on cost (USD):	YES		
Effect on schedule (Days):	NO		
Effect on quality:	NO		
Requested by (Name):	Delgersuren.N	Position:	SMP Engineer
Signature:		Date: (dd/mm/yyyy)	18/01/2022

B. To be completed by Jacobs Field Engineer

Comments/recommendations by Engineering

Proposal #1 is acceptable with the comment.

-The marked in green colour in this TQ page number #7.

-The materials used for the supports shall be in accordance with the project specifications.

-Capture changes in redlines.

*Disclaimer:*

*Acceptance or rejection of this TQ is only related with technical aspects.*

*If Cost or Schedule Impact are associated with this TQ, it must be discussed separately with Jacobs Contract team.*

C. Engineering Decision		D. Information		
<input checked="" type="checkbox"/>	<input type="checkbox"/>	<input type="checkbox"/>	<input type="checkbox"/>	<input type="checkbox"/>
Accept with comments	Reject	<b>Design Change</b> Distribute to: Design Author DA	<b>Cost Impact</b> Distribute to: Contracts, Proj. Controls & Construction Manager	<b>Schedule Impact</b> Distribute to: Proj. Controls & Construction Manager

REVIEWER		APPROVER		CONSTRUCTION MANAGER	
Field Engineer OR Lead Engineer		Lead Engineer OR Chief of Engineering		(If <b>Cost</b> and/or <b>Schedule</b> Impact)	
Date: (dd/mm/yyyy)		Date: (dd/mm/yyyy)		Date: (dd/mm/yyyy)	

## B. To be completed by Jacobs Field Engineer

### Comments/recommendations by Engineering


Proceed as **OPTION#2** with following comments:

- This TQ is accepted only for location of the condenser unit 1693-SRM-2001-AHU-CNDA.
- The Contractor shall be provided gas and liquid pipe route as per Manufacturer recommendation which shows Page-77 on 1693-65-IOM-1500. Prior to installation, separate TQ shall required and confirmed by Worley Reps.



#### Air Cooled Condenser Installation

COOLBLADE DX-M IOM Manual

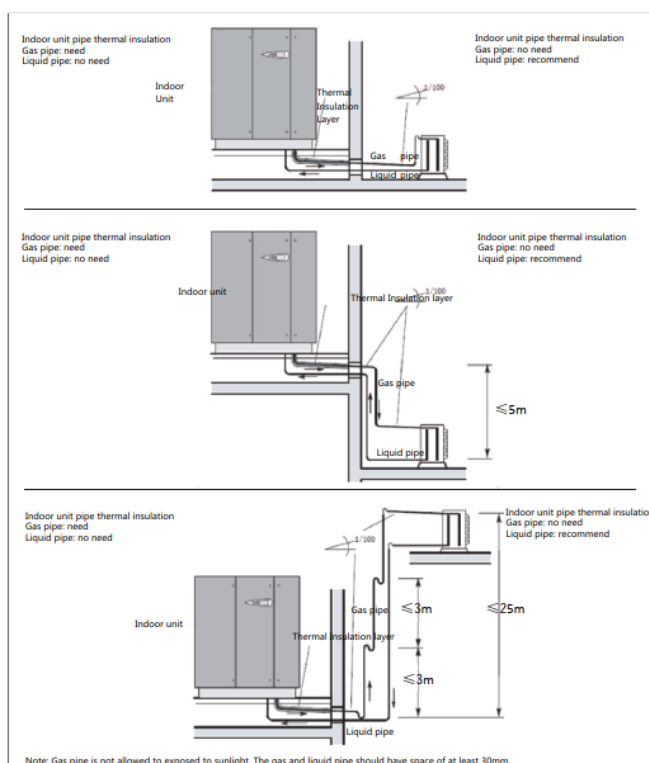

- The Contractor shall be provided Mounting Detail of this relocated condenser unit. Prior to installation, separate TQ shall required and confirmed by Worley Reps.
- Changes shall be redlined on all relevant drawings.


### Disclaimer:



Acceptance or rejection of this TQ is only related with technical aspects.

If Cost or Schedule Impact are associated with this TQ, it must be discussed separately with Jacobs Contract team.

C. Engineering Decision		D. Information		
<input checked="" type="checkbox"/>	<input type="checkbox"/>	<input type="checkbox"/>	<input type="checkbox"/>	<input type="checkbox"/>
Accept with comments	Reject	<b>Design Change</b> Distribute to: Design Author DA	<b>Cost Impact</b> Distribute to: Contracts, Proj. Controls & Construction Manager	<b>Schedule Impact</b> Distribute to: Proj. Controls & Construction Manager

REVIEWER		APPROVER		CONSTRUCTION MANAGER	
Field Engineer OR Lead Engineer		Lead Engineer OR Chief of Engineering		(If <b>Cost</b> and/or <b>Schedule</b> Impact)	
Delger Erdenechuluun		Boldbaatar.M			
Date:	2022.01.13	Date:	2022.01.13	Date:	
(dd/mm/yyyy)	15:25:53	(dd/mm/yyyy)	15:10:48 +08'00'	(dd/mm/yyyy)	

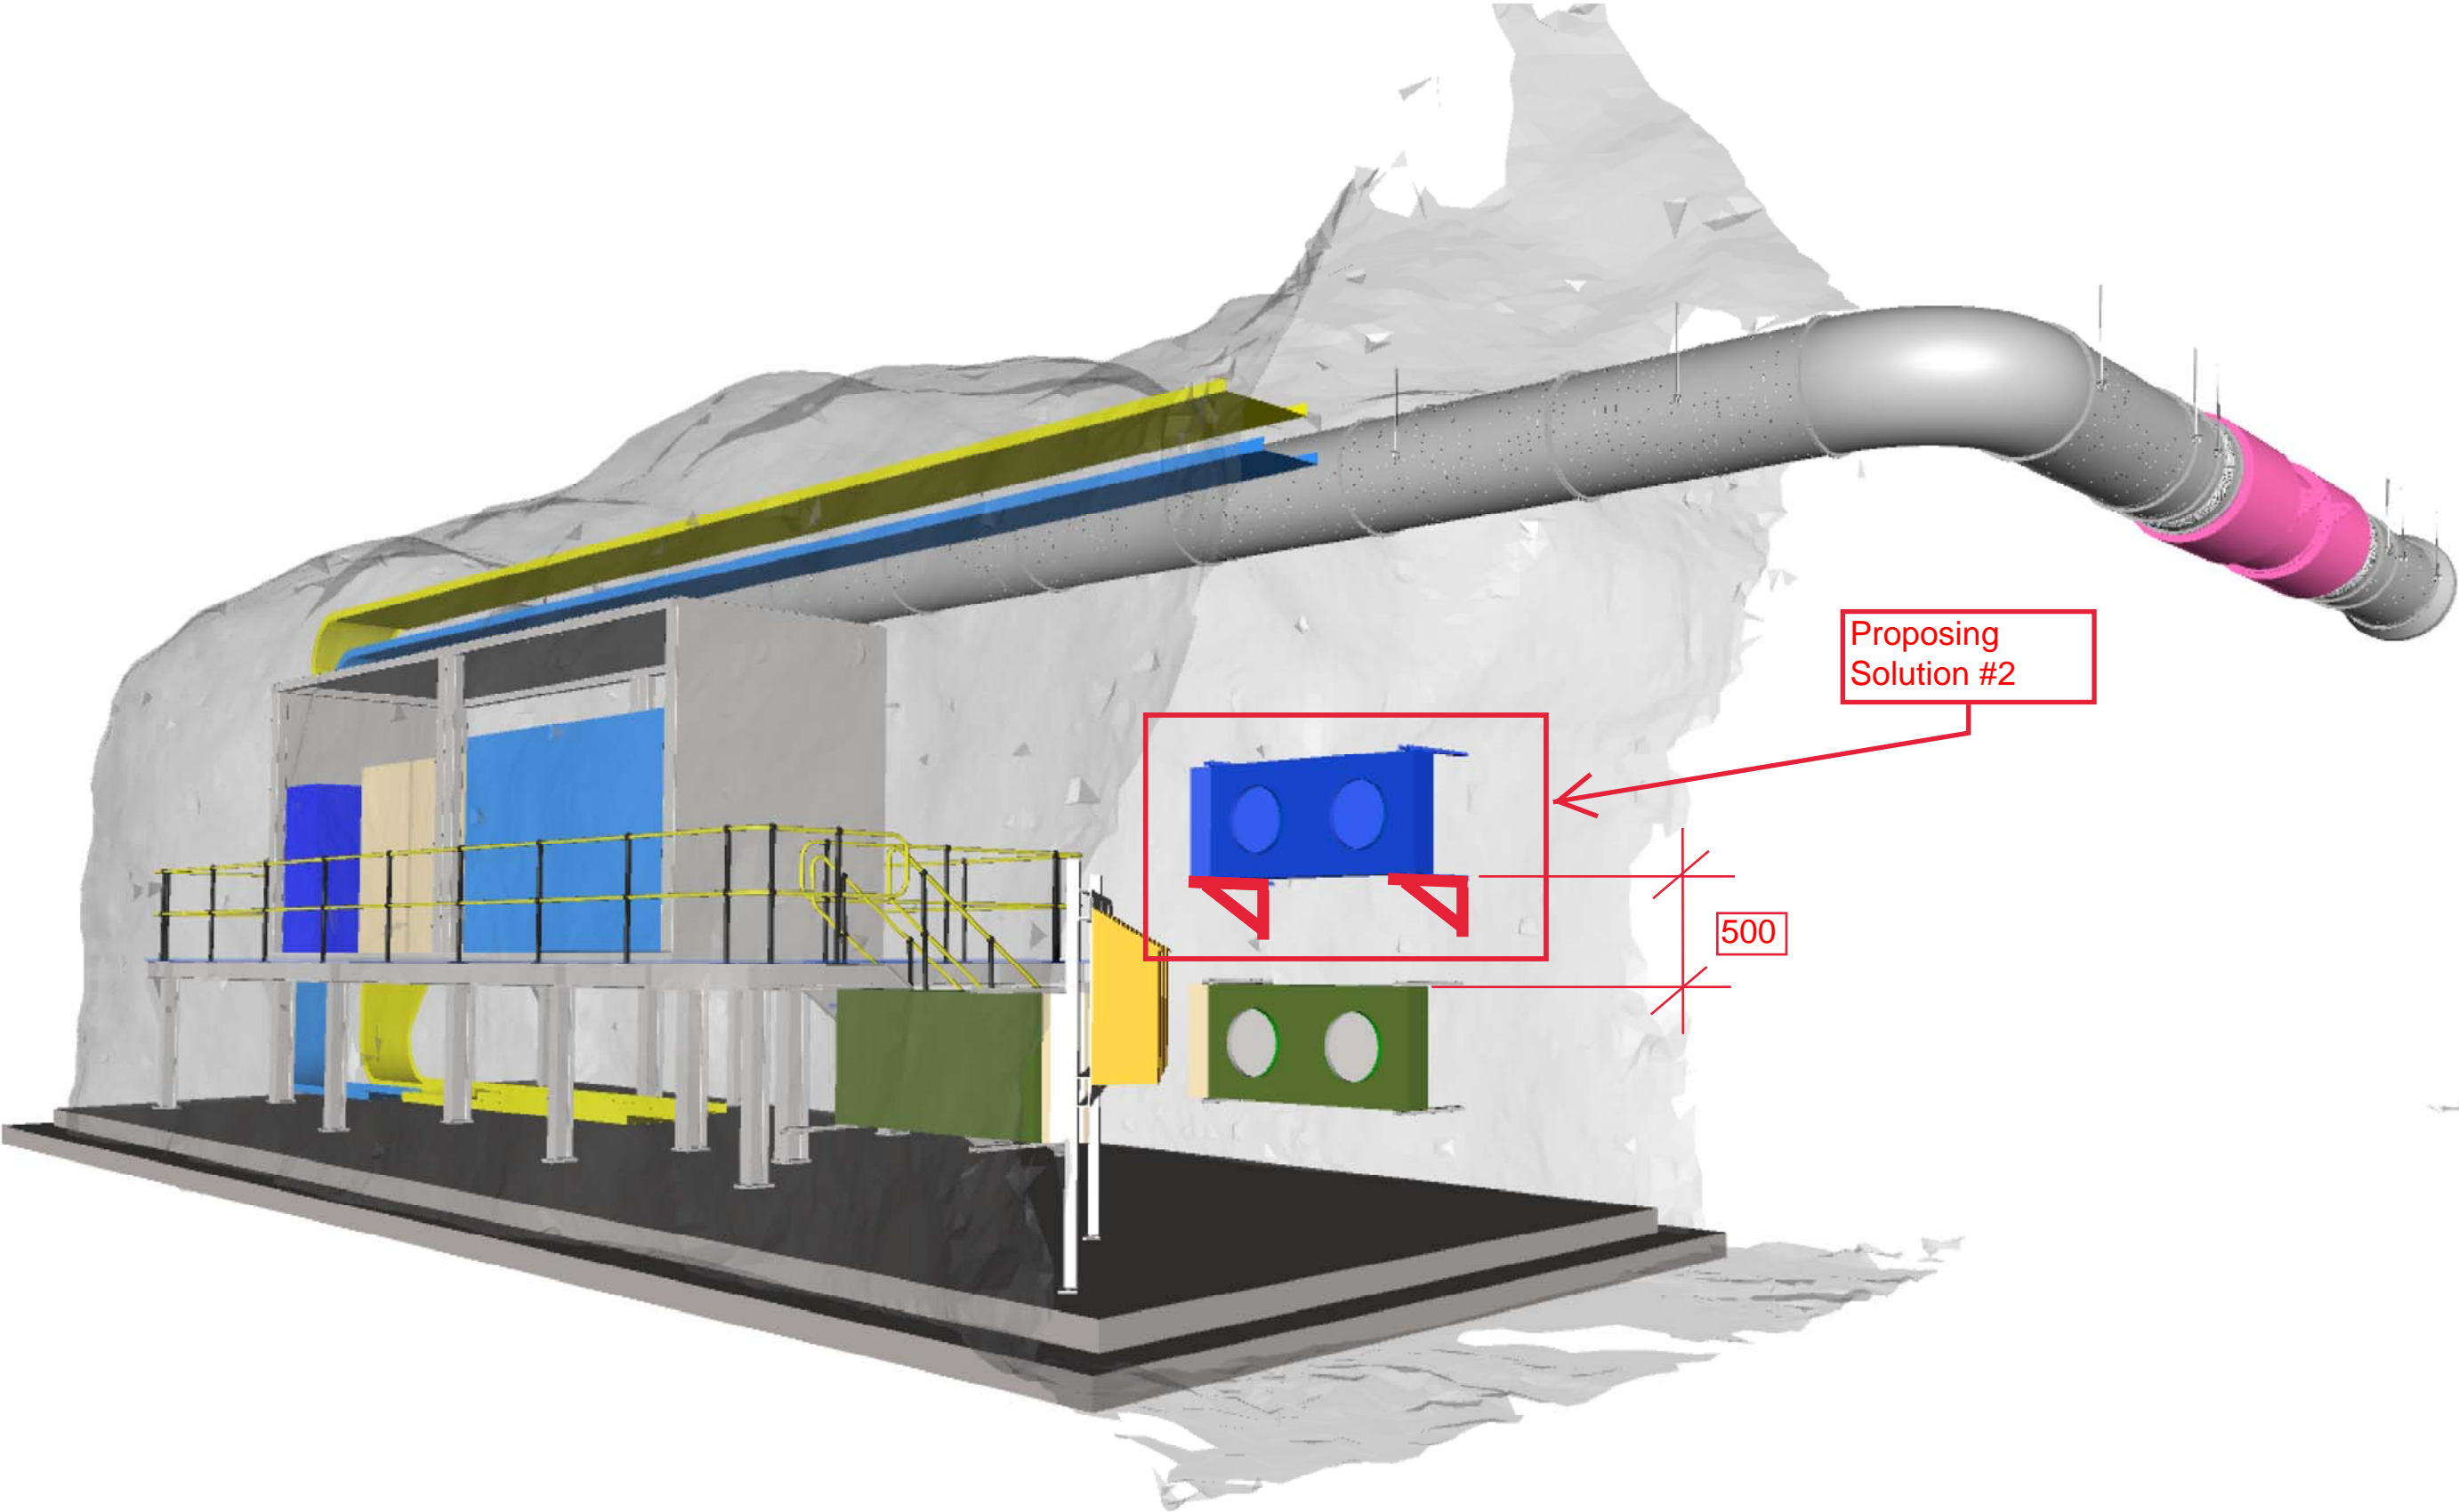
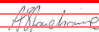


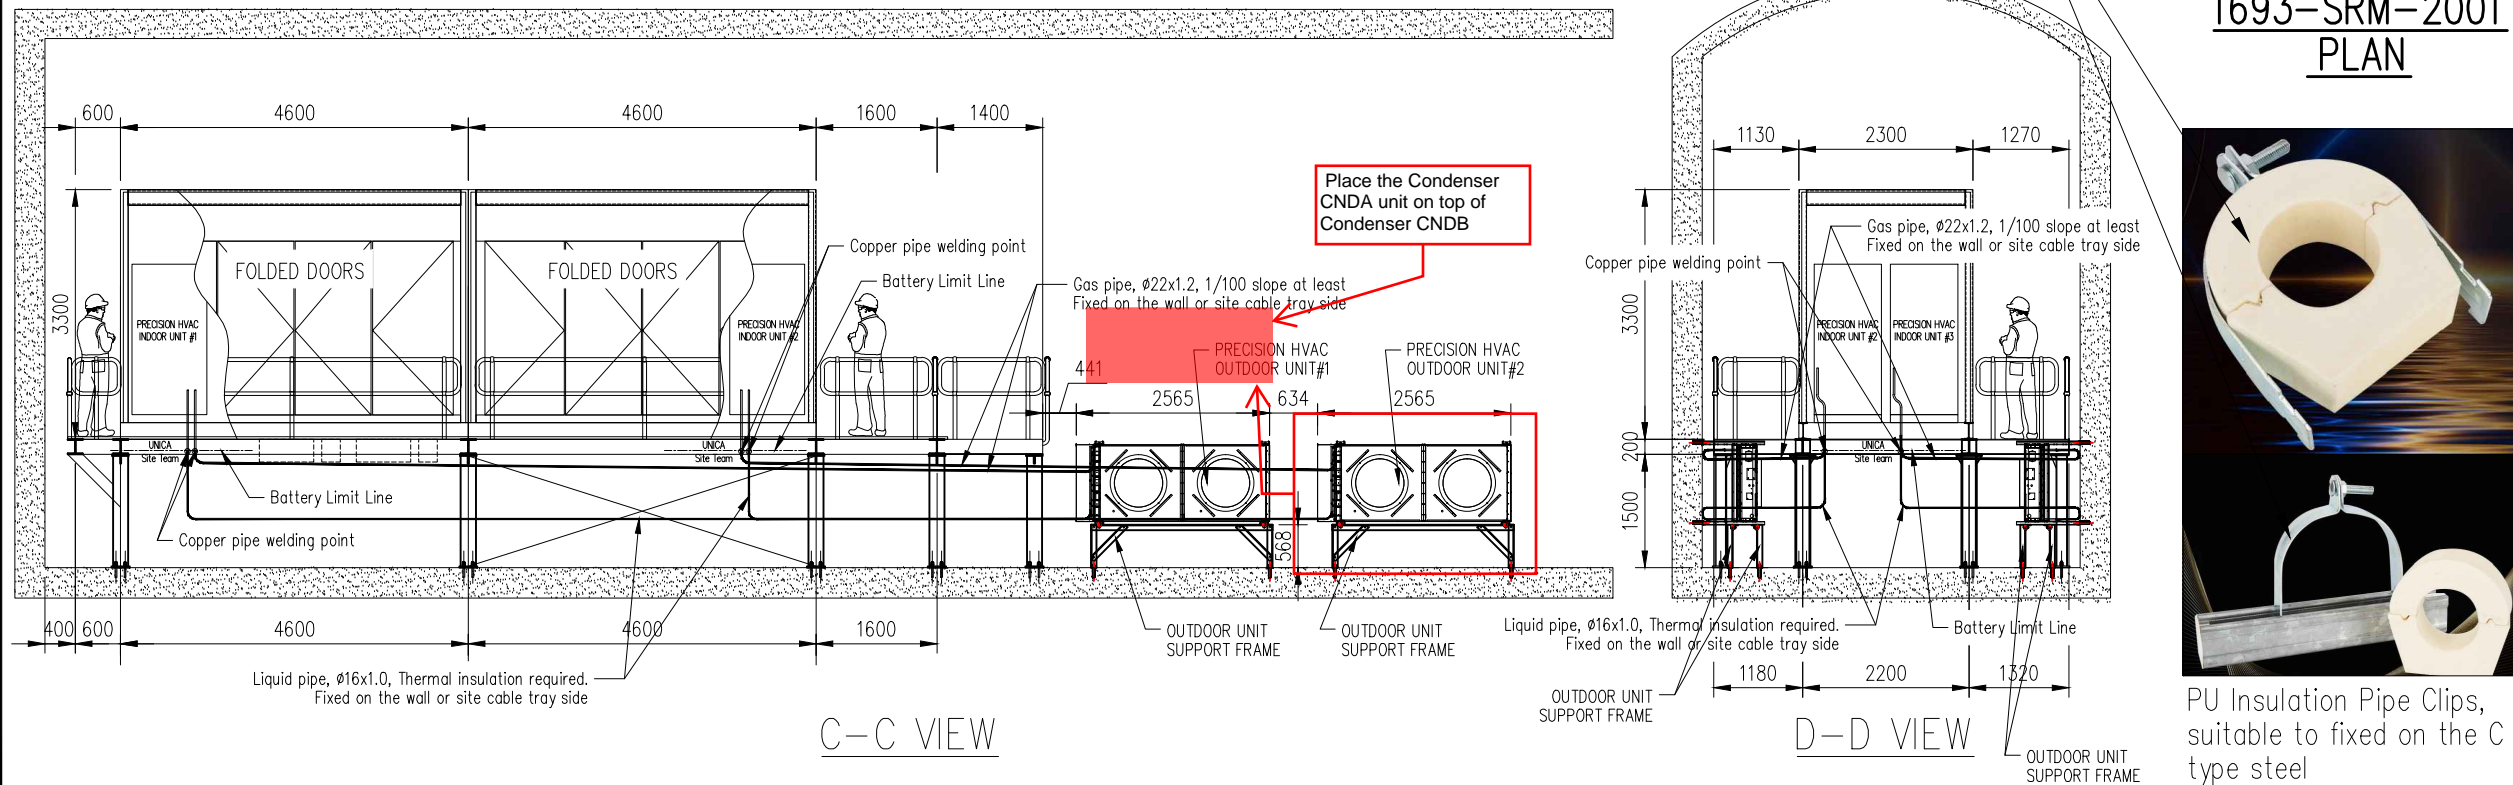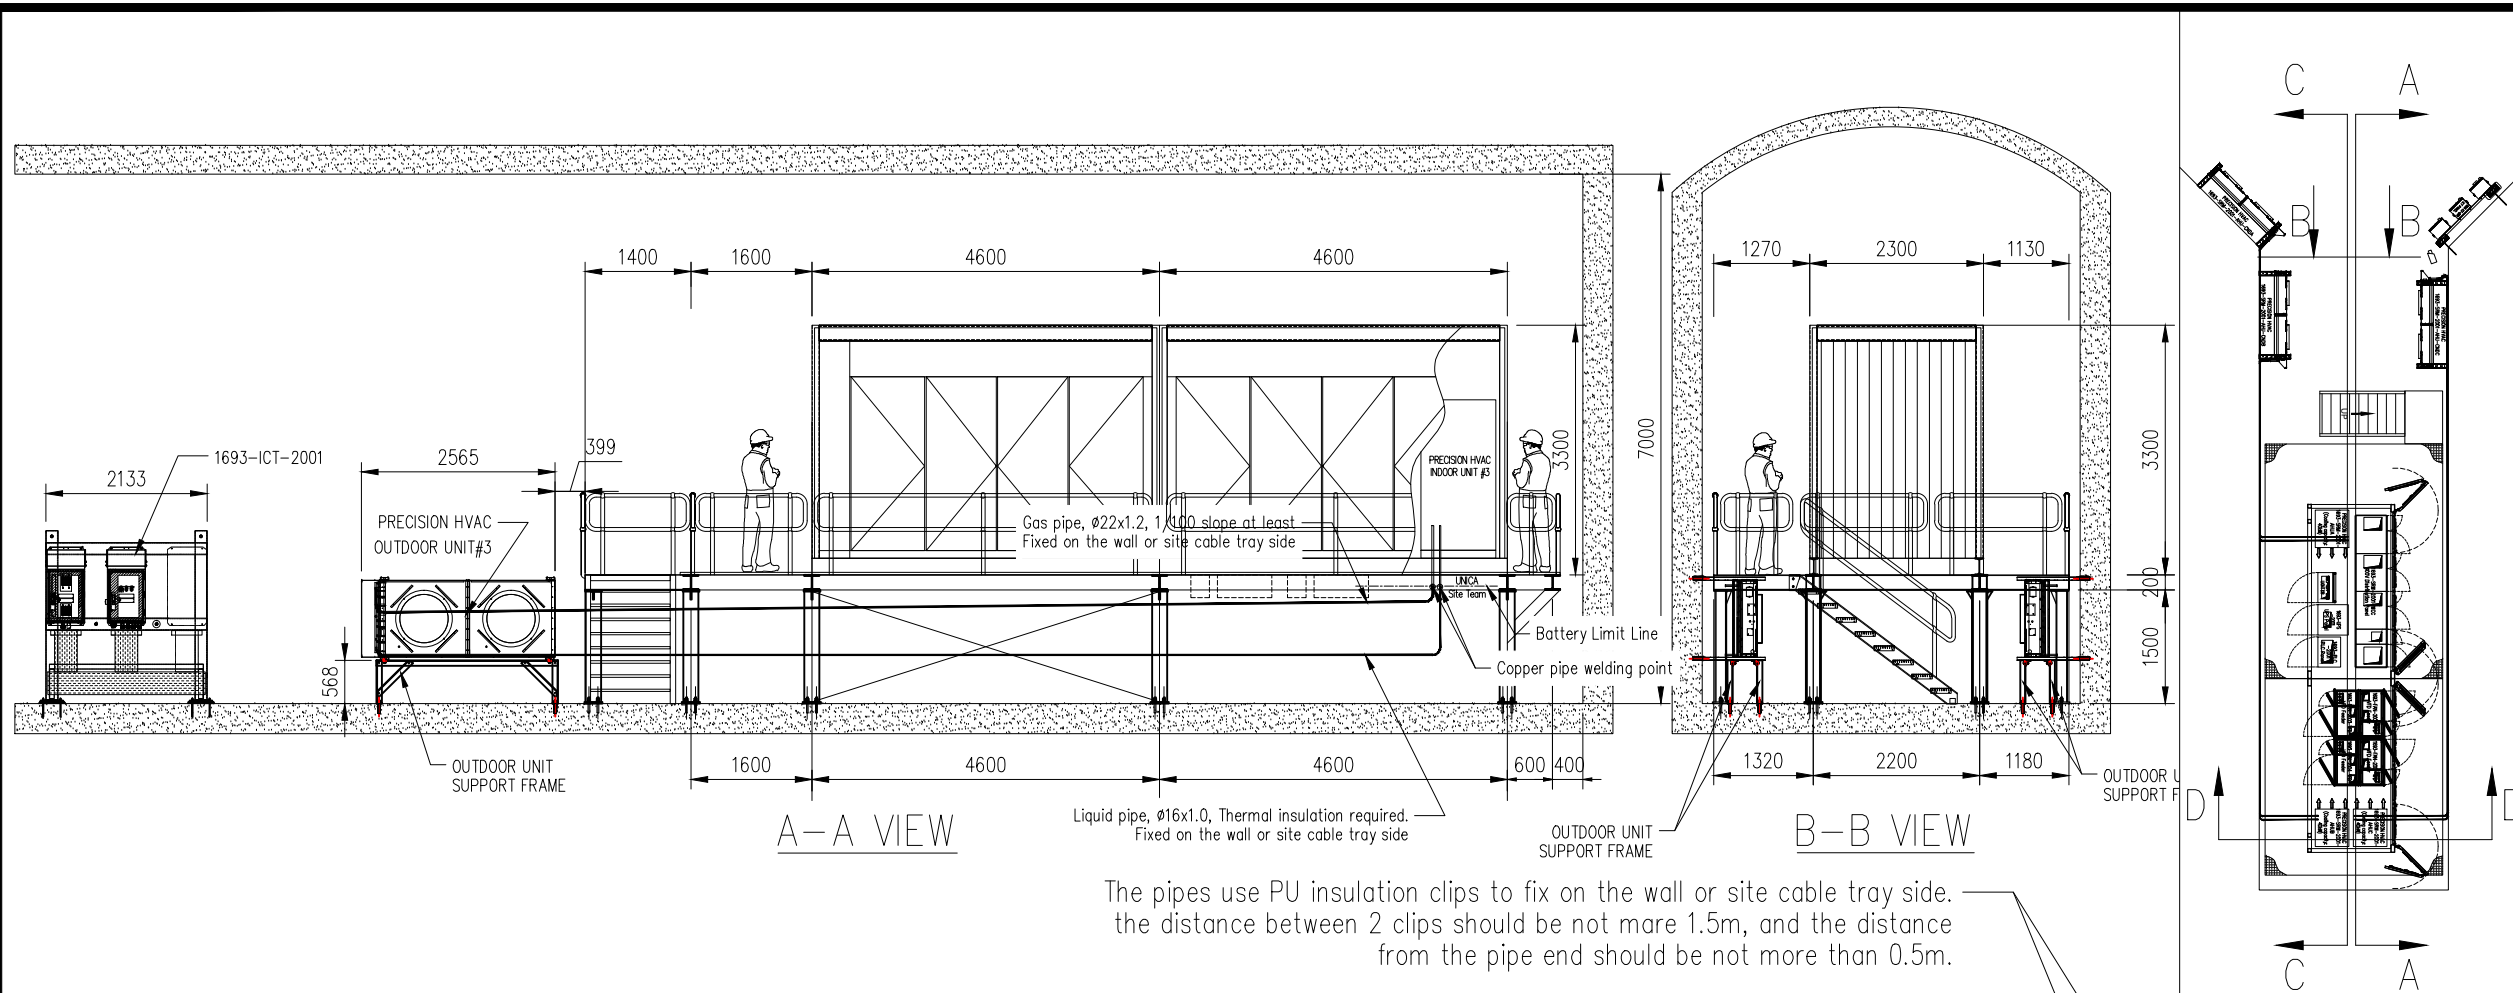

1693-SRM-2001  
PLAN



PU Insulation Pipe Clips,  
suitable to fixed on the C  
type steel

<b>JACOBS</b>		Contractor/Supplier/Vendor Technical Document and Drawing Review for SN1809AD - OT Underground Project			
<input checked="" type="checkbox"/>		1		Reviewed with No Comments. (Construction/Fabrication may Proceed)	
<input type="checkbox"/>		2		Reviewed with Minor Comments. Revise and resubmit "Final Version" incorporating comments. (Construction/Fabrication may proceed thereafter)	
<input type="checkbox"/>		3		Rejected with Major Comments. Correct and resubmit "For Review" incorporating comments. (DO NOT PROCEED with Construction or Fabrication)	
<input type="checkbox"/>		4		Not Reviewed - Received For Information Only. No further submission is required.	
<input type="checkbox"/>		5		Received Certified/Equipment Package Vendor Document. Received As Built - Contractor Document.	
<input type="checkbox"/>		6		Cancelled.	
<input type="checkbox"/>		YES		NO	
Responsible Engineer		Submit Certified Document.			
Name		Signature		Date	
				Date	
				Signed by Andrew Stoddard Responsible Engineer, Contract and Materials New York 08/01/18 09:03 AM +0000	
Equipment Tag No.					
Client Document No.		1693-35-C2-1500			
Jacobs Document No. and Revision		CW2100223-1690-B005-0146_R4			
AUTHORISATION TO PROCEED DOES NOT RELIEVE THE VENDOR/CONTRACTOR OF ANY RESPONSIBILITY, OBLIGATION OR LIABILITY UNDER THE PURCHASE ORDER/CONTRACT. NO RESPONSIBILITY IS ASSUMED BY JACOBS FOR CORRECTNESS OF DIMENSIONS OR DETAILS. SHOP DRAWINGS ARE ACCEPTED AS FOR INFORMATION ONLY (NOT REVIEWED). VENDOR/CONTRACTOR IS FULLY RESPONSIBLE FOR SHOP DRAWINGS.					

NOTE:  
Refrigerant piping shall be seamless copper alloy tubing conforming to applicable ASTM B280 and ANSI B315 or equivalent. Refrigerant piping shall be installed in accordance with ASHRAE 15



Tag No.	1693-SRM-2001
Vendor Drawing No.	1693-SRM-2001_HVAC-PIPING
JACOBS Document No. and Revision	CW2100223-1690-B005-0146_3
Howden Document No.	L000916-6209
VDRS Code:	B005

OYU TOLGOI UNDERGROUND PROJECT UNDERGROUND ELECTRICAL AND INSTRUMENTATION HIGH SPEED NORTH INTAKE BOOSTER FAN ELECTRICAL ROOM HVAC LAYOUT DRAWINGS(1693-SRM-2001-AHUA/AHUB/AHUC)	
SCALE	DRAWING NUMBER
1:100@A3	1693-35-C2-1500
REV.	1

REV.	DATE	REVISION DESCRIPTION	DES. CHK.	APPROVED	REV.	DATE	REVISION DESCRIPTION	DES. CHK.	APPROVED	REFERENCE DRAWING No.	REFERENCE DRAWINGS
0	03/02/2021	ISSUED_FOR_CONSTRUCTION	CC	YZ						1693-65-G2-1513	GENERAL_ARRANGEMENTS_&_LAYOUT_DRAWINGS
1	04/15/2021	ISSUED_FOR_CONSTRUCTION	CC	YZ						1693-65-K2-1503	ELECTRICAL_RACKING_&_ROUTING_DIAGRAM
			CC	YZ						1693-65-Q1-1500	LIGHTING_LAYOUT_DIAGRAM
			CC	YZ						1693-IOM-1500	IOM

Oyu Tolgoi LLC  
ОЮУ ТОЛГОЙ ХХК

Produced by UNICA  
Designed by UNICA  
Drawn by YB

PROJECT NO  
CONTRACT NO  
DRAWING SIZE  
PLOT SCALE  
CADD FILE NAME

AREA PROJECT ENG  
LEAD ENGINEER  
PROJECT MANAGER  
CLIENT


CHECK DRAWING  
APPROVAL DATE  
APPROVAL DATE  
APPROVAL DATE

ENG MANAGER  
APPROVAL DATE  
APPROVAL DATE  
APPROVAL DATE






# OPTION 1

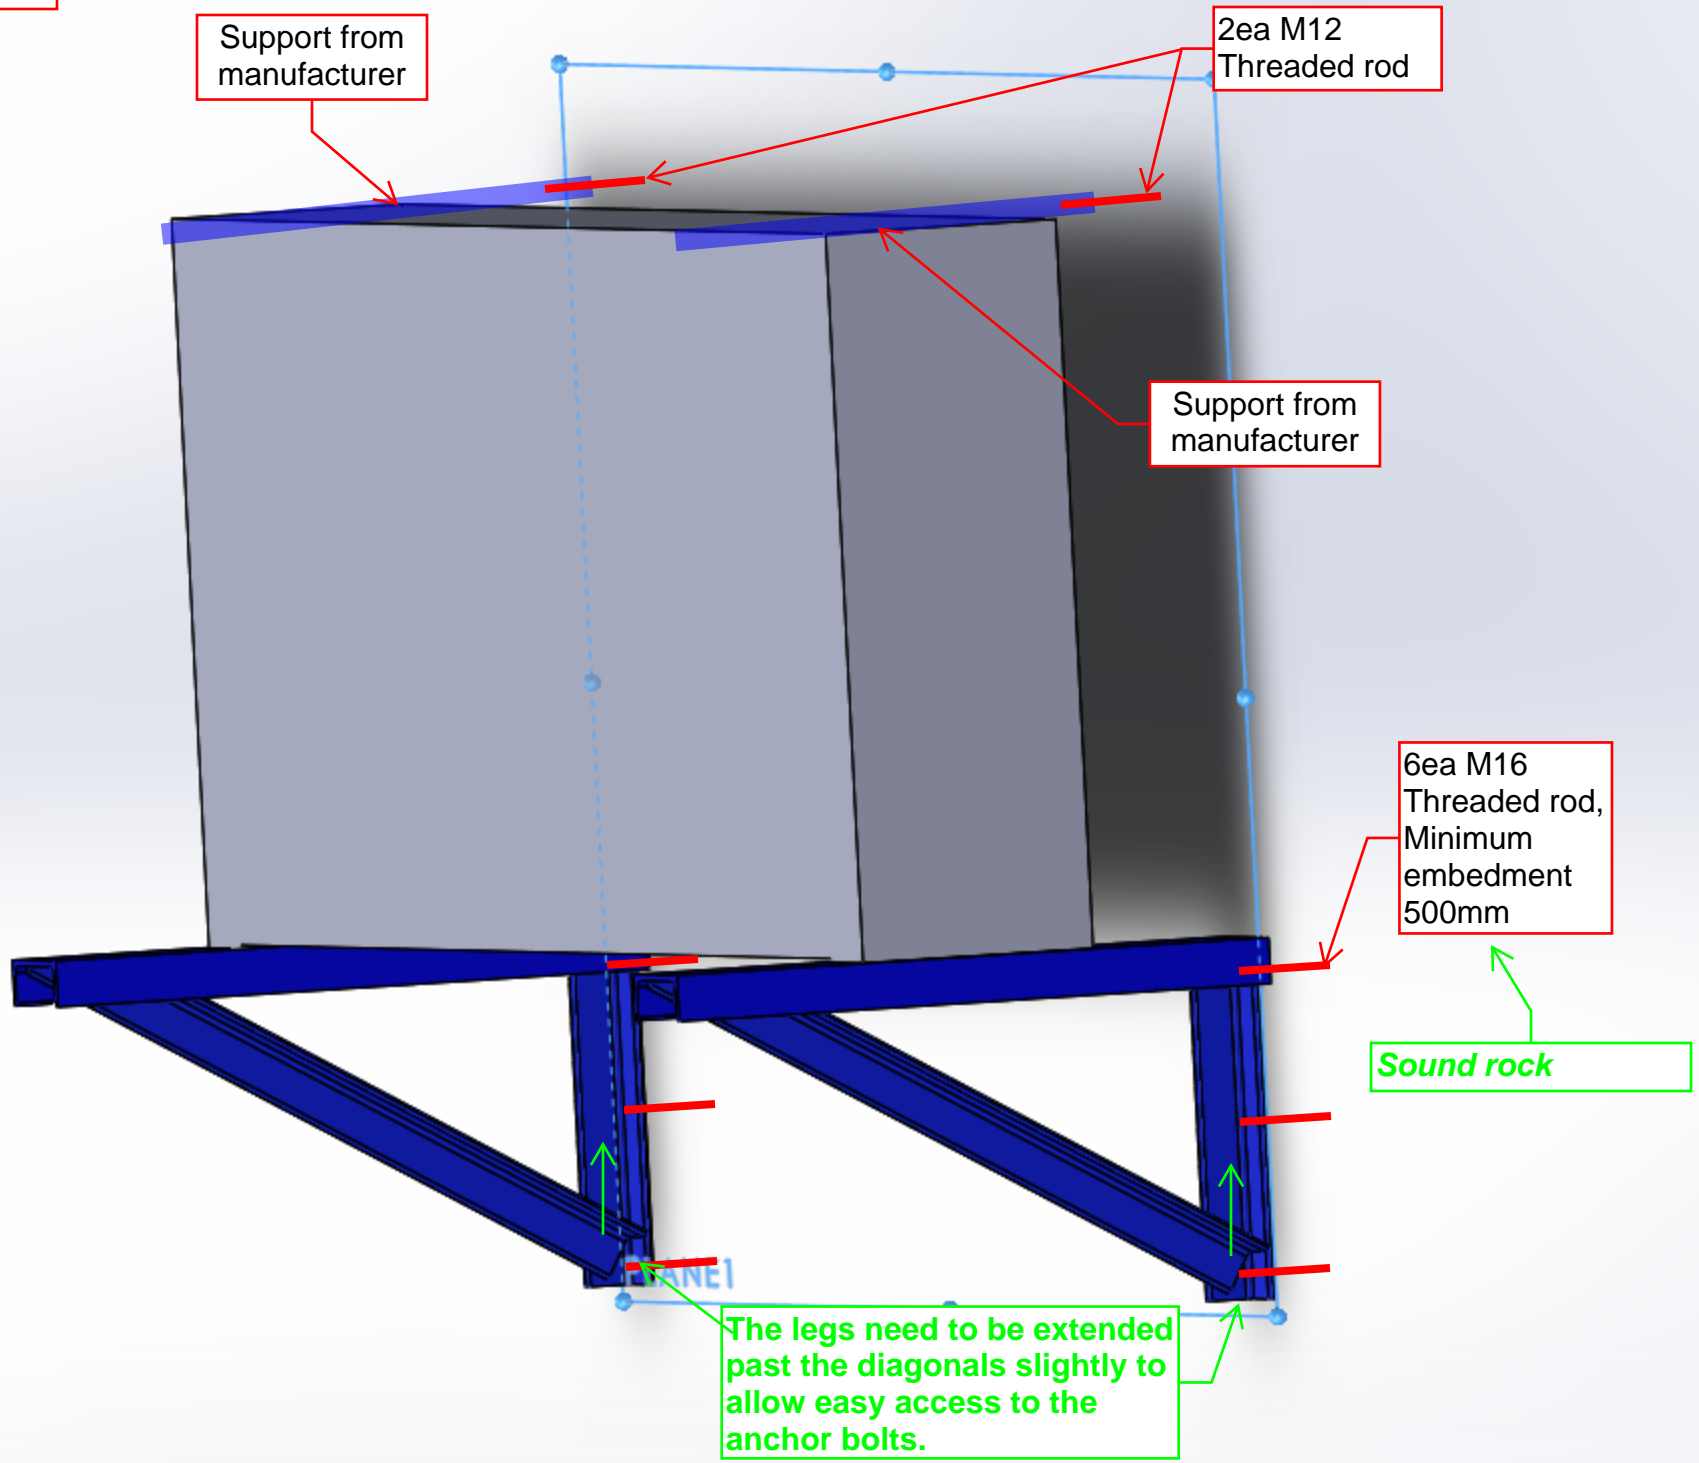

Model name:asem1  
Study name:Static 1(-Default-)  
Plot type: Static nodal stress Stress1  
Deformation scale: 1

von Mises (N/mm<sup>2</sup> (MPa))

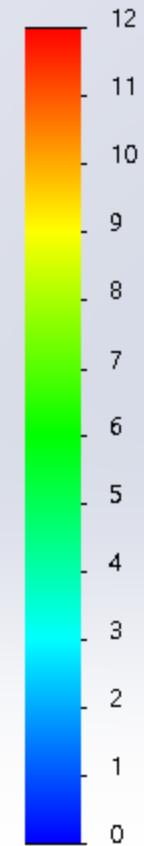

→ Yield strength: 235


Simulated with 135  
kg force on each sup-  
port.

900mm

TFC 05  
160x65

L07 75x8

500mm

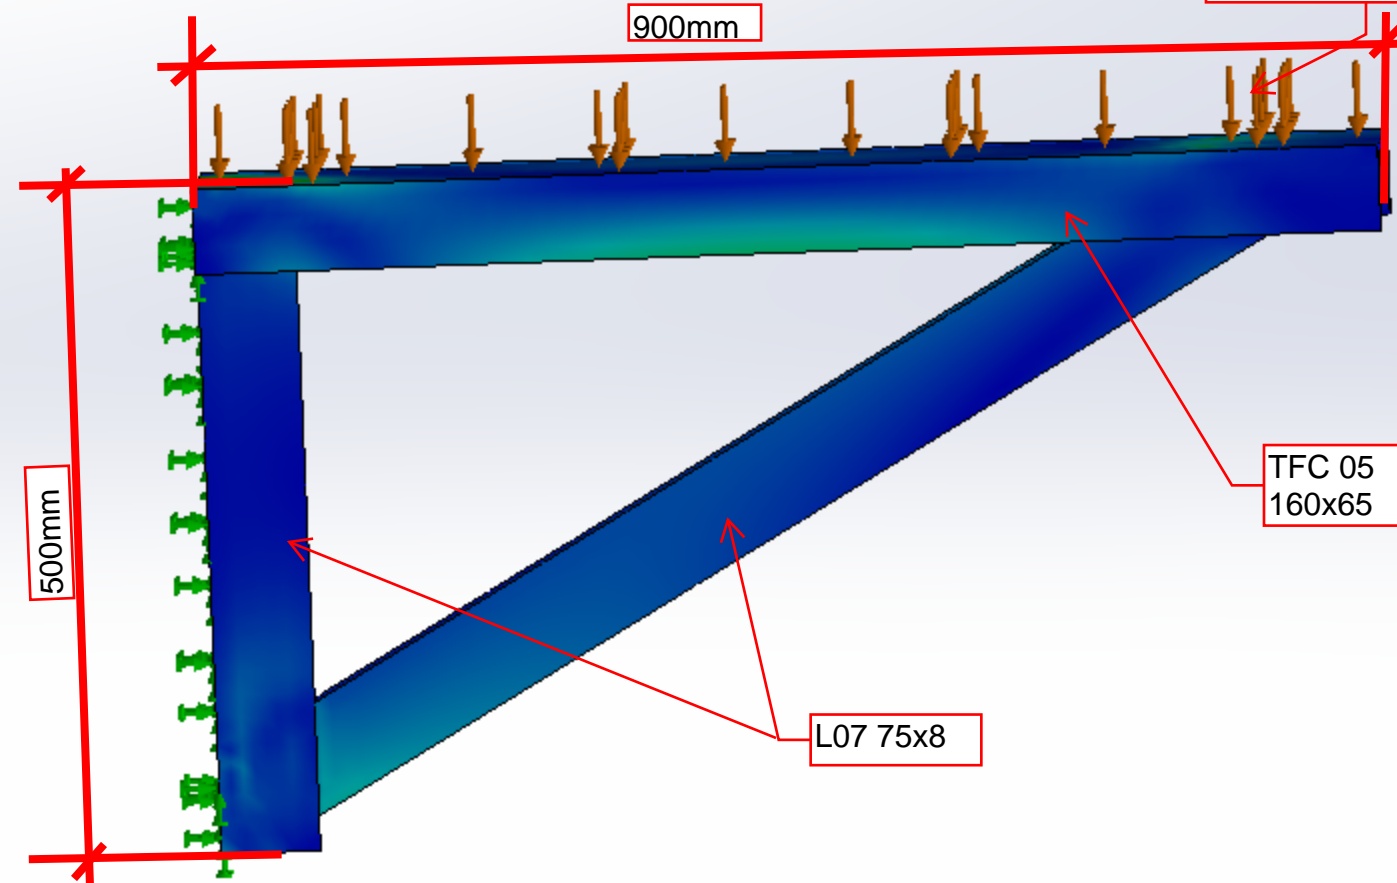




Model name:asem1


Study name:Static 1(-Default-)

Plot type: Static displacement Displacement1

Deformation scale: 1000

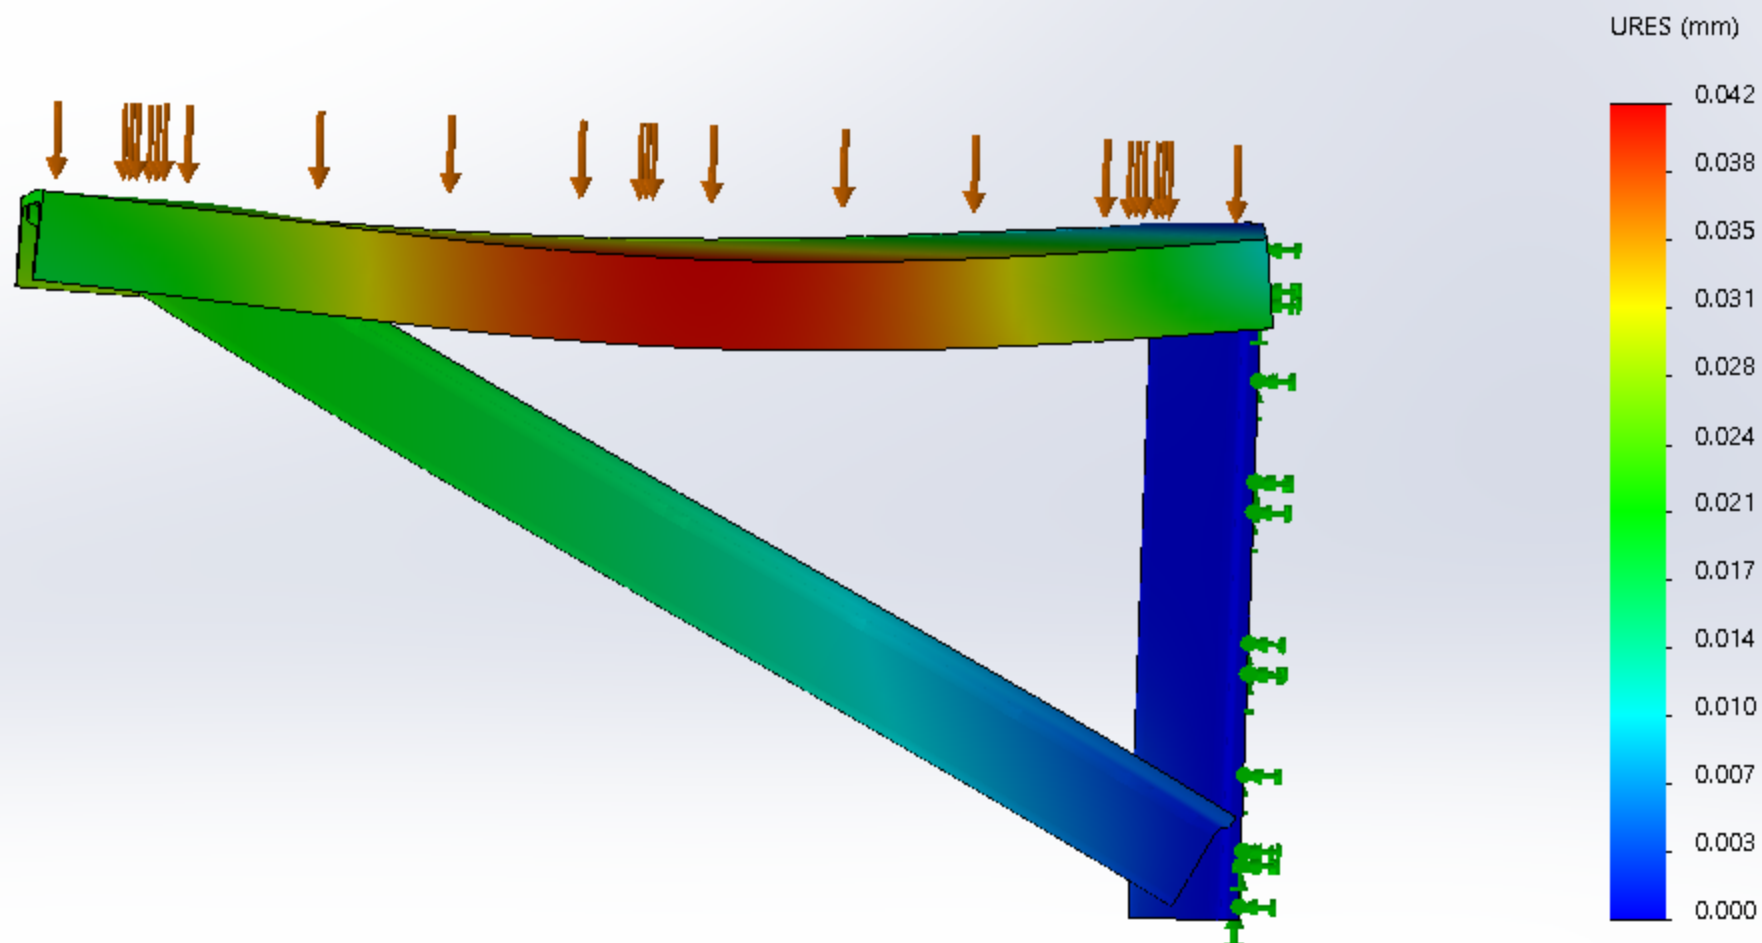


## OPTION 2

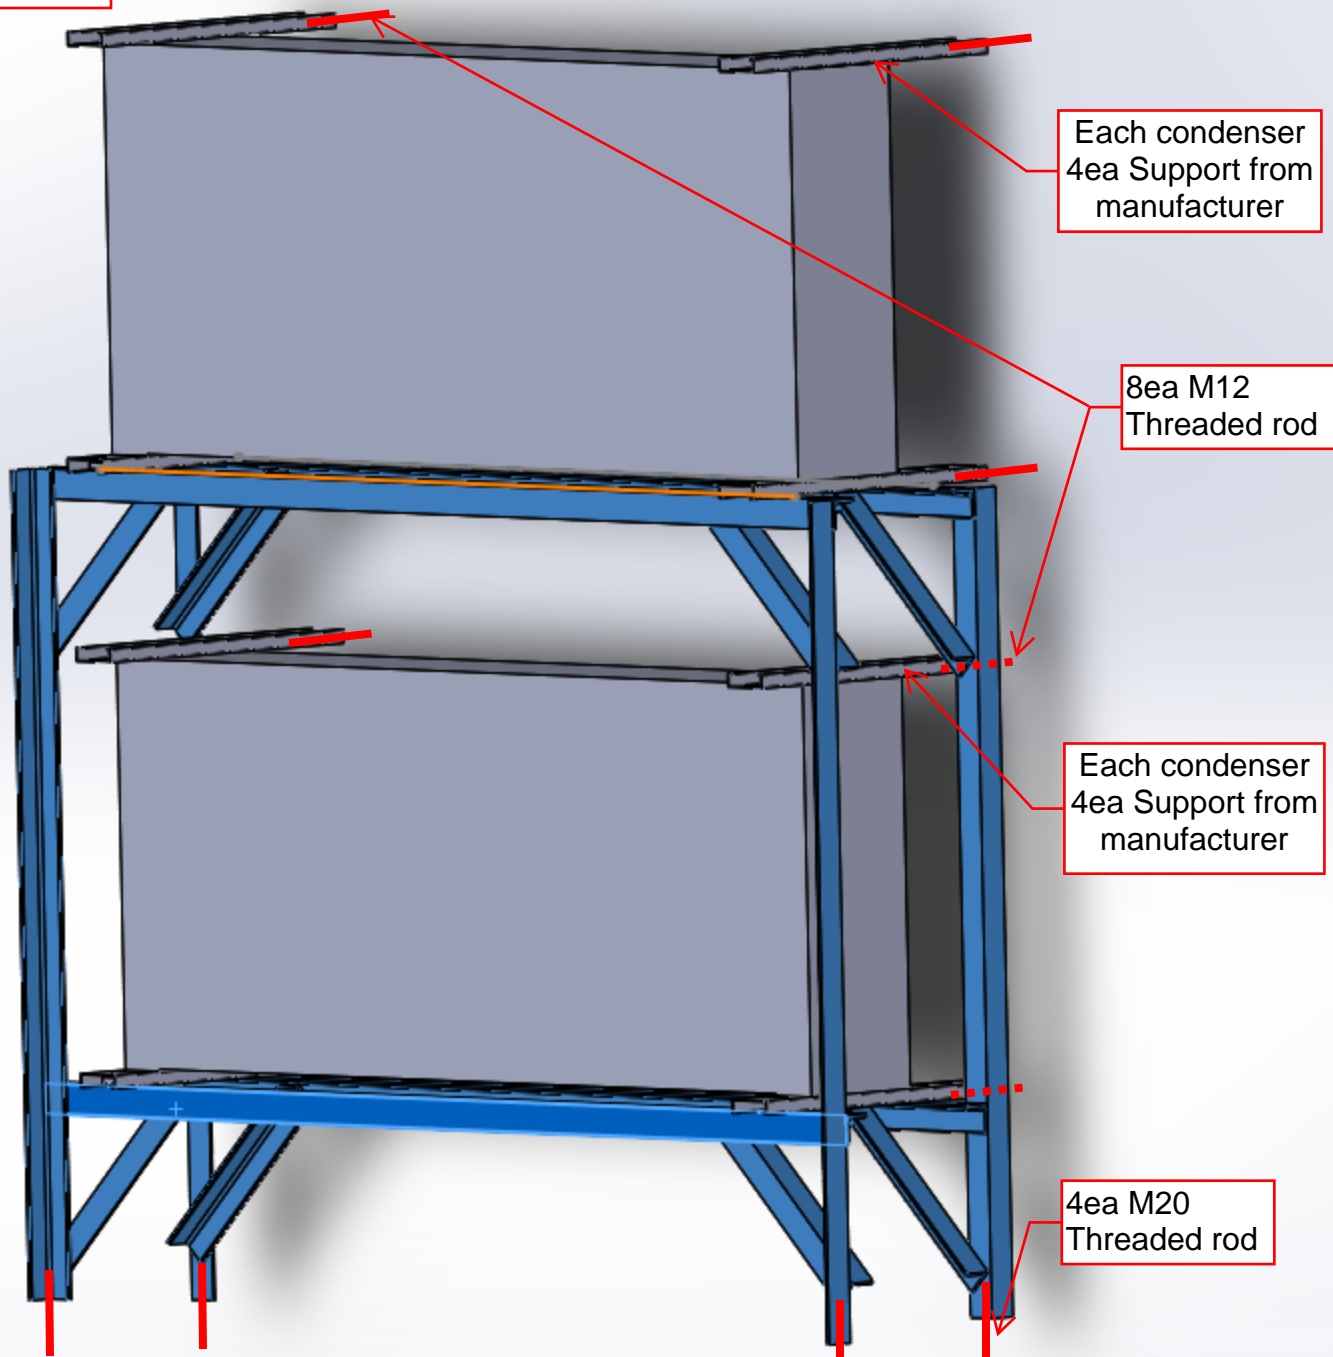


Model name:Supportaaaa  
Study name:Static 5(-Default-)  
Plot type: Static nodal stress Stress1  
Deformation scale: 1

Simulated with 135 kg force on top level of each support.

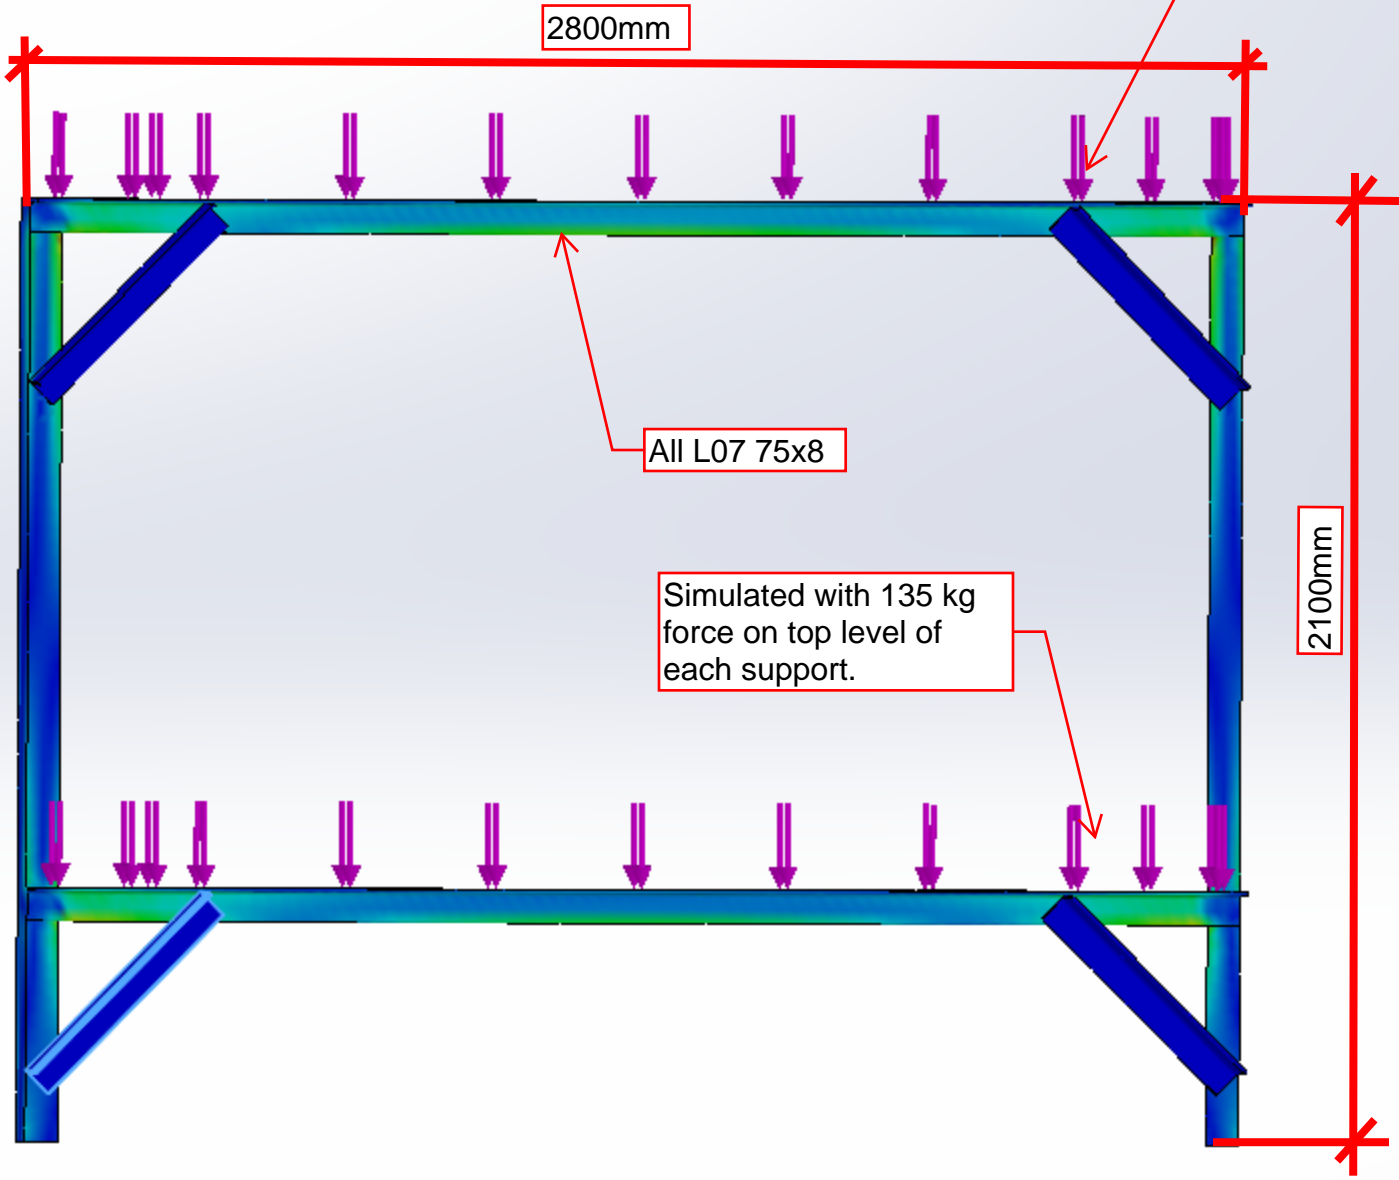

von Mises (N/mm<sup>2</sup> (MPa))

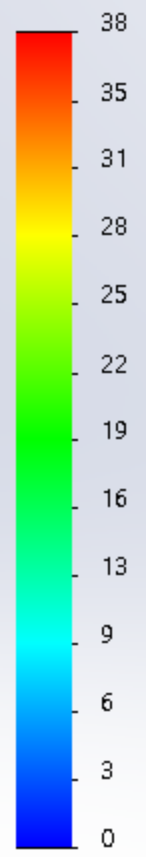

→ Yield strength: 235